


The "Loading Area"

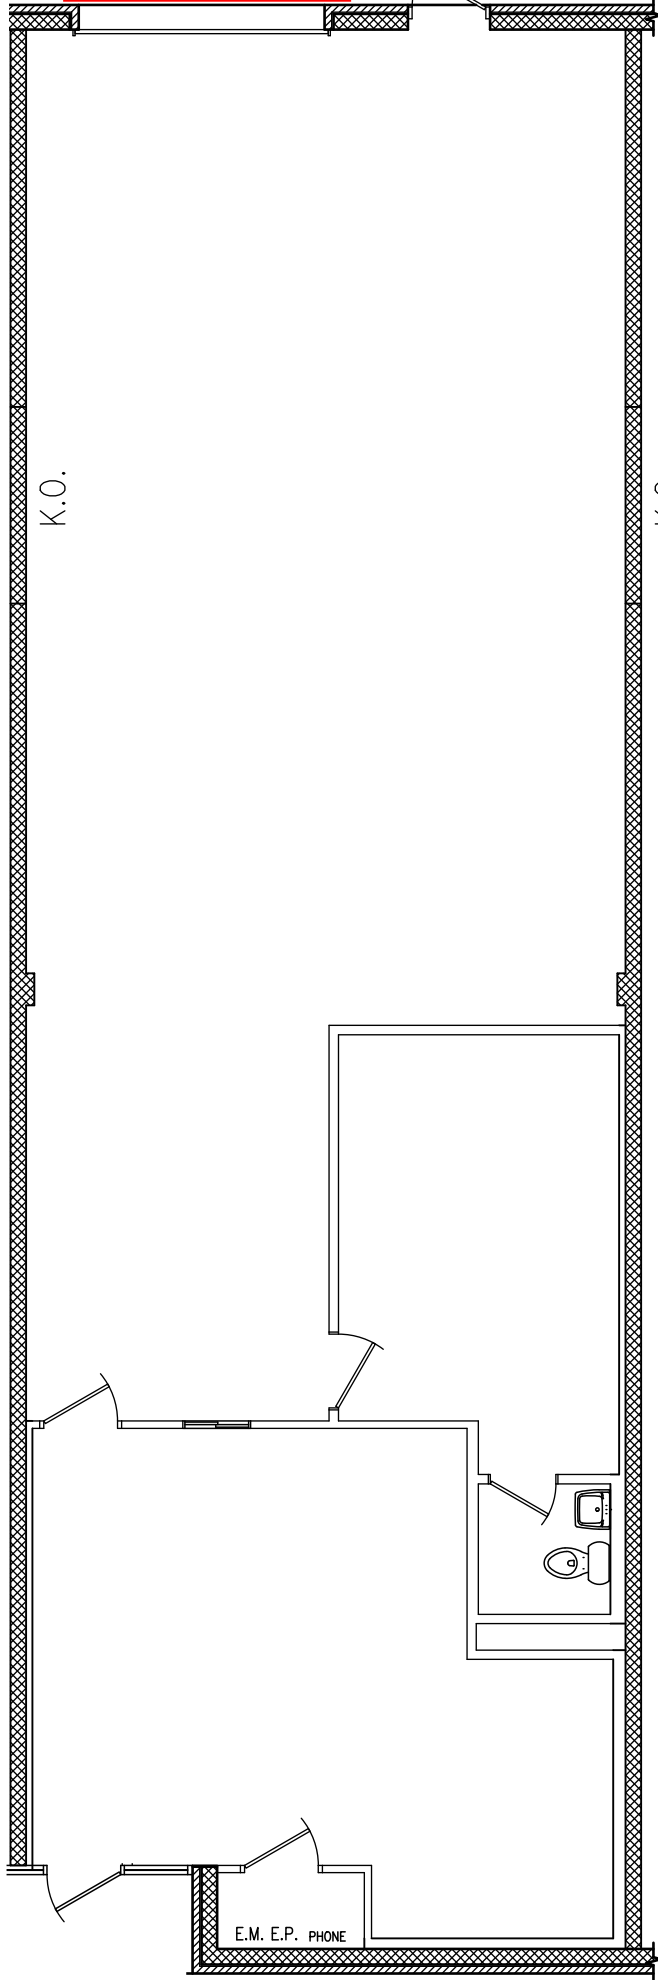

K.O.

K.O.

E.M. E.P. PHONE